

Date: Wednesday, 3/8/2006 10:20:43 AM
 User: Kim Johnston

Process Sheet

15

Customer	: CU-DAR001 Dart Helicopters Services	Drawing Name	: 350 SKIDTUBE ASSEMBLY RH
Job Number	: 26093		
Estimate Number	: 10265		
P.O. Number	: N/A	Part Number	: D350636012
This Issue	: 3/8/2006 S.O. No. : N/A	Drawing Number	: D2750 REV C1
Prsht Rev.	: NC	Project Number	: N/A
First Issue	: N/A Type : LANDING GEAR	Drawing Revision	: C1
Previous Run	: 25571	Material	: N/A
Written By	: SEE COMMENT BELOW	Due Date	: 4/15/2006 Qty: 1 Um: Each
Checked & Approved By	: <u>HA 06.03.08</u>		
Comment	: Est Rev:l 02.09.25 Rearranged procedure steps KJ		

Additional Product

Job Number:



Seq. #:	Machine Or Operation:	Description :
---------	-----------------------	---------------

1.0	DC	DOCUMENT CONTROL
-----	----	------------------



Comment: DOCUMENT CONTROL

Photocopy blue file and type labels per PPP D350-636-012 CHG 001

DH 06/03/21 ①

2.0	D26003BENT	Extrusion Bent
-----	------------	----------------



Comment: Qty.: 1.0000 Each(s)/Unit Total : 1.0000 Each(s)

Pick:

Qty Part Number Description Batch

1 D2600-3-Bent Extrusion (Bent)

B25384 Pm 06-03-10 ①

3.0	D2744	Fwd Cap
-----	-------	---------



Comment: Qty.: 1.0000 Each(s)/Unit Total : 1.0000 Each(s)

Pick:

Qty Part Number Description Batch

1 D2744 Cap

B 24672 BE 06-03-14 ①

4.0	LANDING GEAR 1	LANDING GEAR RESOURCE 1
-----	----------------	-------------------------



Comment: LANDING GEAR RESOURCE 1

1-Cut D2600-3-Bent aft end to length as per Dwg D2750 Mark cut line using Jig DT 8150. Deburr end Pm 06-03-10 ①

2-Drill pilot holes as per Dwg D2750 sheet 3 (D2750-1) and mark fwd end for cutting using Drill Jig DT 8150. Second side of Detail B to be Drilled using DT 8330 Pm 06-03-10 ①

3-Open up holes for Detail B, D and 2 aft 0.500" AE holes to finished size as per Dwg D2750 and DEO 9133 Do not open any 0.625" AE holes to finished size Pm 06-03-14 ①

4-Drill pilot holes as per Dwg D2750 (Sheet 3, D2750-2), mark Fwd end for cutting using Drill Jig Pm 06-03-14 ①

User:

Kim Johnston

Process Sheet

Customer: CU-DAR001 Dart Helicopters Services

Drawing Name: 350 SKIDTUBE ASSEMBLY RH

Job Number: 26093

Part Number: D350636012

Job Number:



Seq. #:

Machine Or Operation:

Description :

DT8150, then drill both sides.

5-Open holes as per detail "P" To 500", then Drill pilot holes to detail "B" using DT8329

Make sure that wearplate holes are on bottom of tube**

6-Open holes to .500" as per detail "B&C".

7-Open holes to .375" as per detail "D"

8-Cut fwd end of tube as per Dwg D2750

9-Drill pilot holes for wearplates using DT 8108 Open holes to 0.297" and Open holes per Dwg D2750 detail

A

10-Open holes to .590" as per detail "D".

11-Deburr

12-Weld D2744 Cap as per Dwg D2750 and QSI 004. Fill grooves in bend left from bending as per QSI 004.

A/R

Aluminum Rod

13-Grind welds flush as per Dwg D2750

5.0

HAND FINISHING1

HAND FINISHING RESOURCE #1



Comment: HAND FINISHING RESOURCE #1

Chemical Conversion Coat as per QSI 005 4.1

6.0

QC5/9

WELD INSPECTION



Comment: WELD INSPECTION

7.0

D2739

350 I Beam



Comment: Qty.: 1.0000 Each(s)/Unit Total : 1.0000 Each(s)

Pick:

Qty Part Number

Description

Batch

1 D2739

Web

06-03-16
B212207 BE

06-03-16

06-03-16

Process Sheet

Drawing Name: 350 SKIDTUBE ASSEMBLY RH

Customer: CU-DAR001 Dart Helicopters Services

Part Number: D350636012

Job Number: 26093

Job Number: 

Seq. #:	Machine Or Operation:	Description :
8.0	D2743	Crossbolt Spacer

Comment: Qty.: 8.0000 Each(s)/Unit Total: 8.0000 Each(s)

Pick: Qty Part Number Description Batch
8 D2743 Crossbolt spacer B 24641 BE 06-03-17 (1)

9.0	LANDING GEAR 1	LANDING GEAR RESOURCE 1
-----	----------------	-------------------------

Comment: LANDING GEAR RESOURCE 1

1-Open 0.625" \pm holes and countersink for welding crossbolt spacers as per Dwg D2750. Do not use cutting oil BE 06-03-16 (1)

2-Deburr and blow out all chips from inside of tube BE 06-03-16 (1)

3-Bond web D2739 in place as per QSI 015
A/R Sikaflex-291 119597 BE 06-03-16 400
Sikaflex expire date: 06-06-18

4-Weld crossbolt spacers D2743 as per Dwg D2750 and QSI 004
A/R Aluminum Rod M19100 BE 06-03-17 (1)

5-Grind welds flush as per Dwg D2750 ET 06-03-17 (1)

6-Spot face ground handling holes \pm 0.750" (8 places) BE 06-03-20 (1)

7-Deburr holes BE 06-03-20 (1)

10.0	QC5/9	WELD INSPECTION
------	-------	-----------------

Comment: Inspect weld and work to Step 20

11.0	POWDER COATING	POWDER COATING
------	----------------	----------------

Comment: POWDER COATING
Powder Coat Gloss White (Ref. 4.3.5.1) as per Dart QSI 005 4.3 a.m 06-04-11 (1)

12.0	QC3	INSPECT POWDER COAT/CHEMICAL CONVERSION
------	-----	---

Comment: INSPECT POWDER COAT/CHEMICAL CONVERSION
Inspect for foreign object per QSI 024

DL 06/04/12 (1)

Date: Wednesday, 3/8/2006 10:29:44 AM
User: Kim Johnston

Process Sheet

Customer: CU-DAR001 Dart Helicopters Services

Drawing Name: 350 SKIDTUBE ASSEMBLY RH

Job Number: 26093

Part Number: D350636012

Job Number:



Seq. #:

Machine Or Operation:

Description :

13.0

D27422

Blade Fitting, RH



Comment: Qty.: 1.0000 Each(s)/Unit Total : 1.0000 Each(s)

Pick:

Qty	Part Number	Description	Batch
1	D2742-2	Blade Fitting, LH	024640

14.0

AN835A

Bolt



Comment: Qty.: 1.0000 Each(s)/Unit Total : 1.0000 Each(s)

Pick:

Qty	Part Number	Description	Batch
1	AN8-35A	Bolt	M18576

15.0

AN960JD816

1/2" washer, Alum



Comment: Qty.: 2.0000 Each(s)/Unit Total : 2.0000 Each(s)

Pick:

Qty	Part Number	Description	Batch
2	AN960JD816	Washer	M6956

16.0

MS21083N8

Nut



Comment: Qty.: 1.0000 Each(s)/Unit Total : 1.0000 Each(s)

Pick:

Qty	Part Number	Description	Batch
1	MS21083N8	Nut	M19185

17.0

D26483

Wearpad



Comment: Qty.: 5.0000 Each(s)/Unit Total : 5.0000 Each(s)

Pick:

Qty	Part Number	Description	Batch
5	D2648-3	Wearpad	B 24243-2

18.0

D265613

Wearplate



Comment: Qty.: 1.0000 Each(s)/Unit Total : 1.0000 Each(s)

Pick:

Qty	Part Number	Description	Batch
1	D2656-13	Wearplate	R 23329

9. m 06-04-13

Date: Wednesday, 3/8/2006 10:29:44 AM
User: Kim Johnston

Process Sheet

Customer: CU-DAR001 Dart Helicopters Services

Drawing Name: 350 SKIDTUBE ASSEMBLY RH

Job Number: 26093

Part Number: D350636012

Job Number:



Seq. #: Machine Or Operation: Description :

19.0 D265635 Wearplate



Comment: Qty.: 1.0000 Each(s)/Unit Total : 1.0000 Each(s)

Pick:

Qty	Part Number	Description	Batch
1	D2656-35	Wearplate	325330

20.0 D2746 Wearshoe



Comment: Qty.: 1.0000 Each(s)/Unit Total : 1.0000 Each(s)

Pick:

Qty	Part Number	Description	Batch
1	D2746	Wearplate	024149

21.0 ALS41032225 Insert



Comment: Qty.: 46.0000 Each(s)/Unit Total : 46.0000 Each(s)

Pick:

Qty	Part Number	Description	Batch
46	ALS4-1032-225 (or AKS4-1032-225) (or ALS7-1032-225) (or AKS7-1032-225)	Insert	M18293

22.0 AN960JD10L Washer



Comment: Qty.: 42.0000 Each(s)/Unit Total : 42.0000 Each(s)

Pick:

Qty	Part Number	Description	Batch
42	AN960JD10L	Washer	M19185

23.0 AN35A Bolt



Comment: Qty.: 38.0000 Each(s)/Unit Total : 38.0000 Each(s)

Pick:

Qty	Part Number	Description	Batch
38	AN3-5A	Bolt	M15705

u.m 06-04-12

Date: Wednesday, 3/8/2006 10:29:44 AM.
User: Kim Johnston

Process Sheet

Customer: CU-DAR001 Dart Helicopters Services

Drawing Name: 350 SKIDTUBE ASSEMBLY RH

Job Number: 26093

Part Number: D350636012

Job Number:



Seq. #:

Machine Or Operation:

Description :

29.0

A3235020935

Washer - Countersunk



Comment: Qty.: 8.0000 Each(s)/Unit Total : 8.0000 Each(s)

Pick:

Qty	Part Number	Description	Batch
8	A3235-020-935	Plug	M10369

30.0

MS21042L3

Nut



Comment: Qty.: 4.0000 Each(s)/Unit Total : 4.0000 Each(s)

Pick:

Qty	Part Number	Description	Batch
4	MS21042L3	Nut	M6931

31.0

AN36A

Bolt



Comment: Qty.: 4.0000 Each(s)/Unit Total : 4.0000 Each(s)

Pick:

Qty	Part Number	Description	Batch
4	AN3-6A	Bolt	M100274

32.0

AN960JD10

Washer



Comment: Qty.: 4.0000 Each(s)/Unit Total : 4.0000 Each(s)

Pick:

Qty	Part Number	Description	Batch
4	AN960JD10	Washer	M16066

Q.m 06-04-18

33.0

HAND FINISHING1

HAND FINISHING RESOURCE #1



Comment: HAND FINISHING RESOURCE #1

1-Assemble as per Dwg D2750 Page 4 Detail P. Install D2742-2 and seal with Sikaflex adhesive prior to installing aft most wearpad. Ensure holes are properly aligned.

A/R Sikaflex-291

Sikaflex expire date: 06-11-06

M100480

Q.m 06-04-18

2-Install inserts & wearplates as per Dwg. D2750 Detail K & Q and IIN-D350-636 Page 4. Use a drop of Sikaflex in insert holes before installing wearpad/wearplate. AN3-6A bolts are installed AFT.

A/R Sikaflex-291

Sikaflex expire date: 06-11-06

M100480

Q.m 06-04-18

Date: Wednesday, 3/8/2006 10:29:44 AM
User: Kim Johnston

Process Sheet

Customer: CU-DAR001 Dart Helicopters Services

Drawing Name: 350 SKIDTUBE ASSEMBLY RH

Job Number: 26093

Part Number: D350636012

Job Number:



Seq. #:	Machine Or Operation:	Description :
---------	-----------------------	---------------

24.0	AN36A	Bolt
------	-------	------



Comment: Qty.: 4.0000 Each(s)/Unit Total : 4.0000 Each(s)

Pick:

Qty	Part Number	Description	Batch
4	AN3-6A	Bolt	M100279 /

25.0	D2745	Bushing
------	-------	---------



Comment: Qty.: 8.0000 Each(s)/Unit Total : 8.0000 Each(s)

Pick:

Qty	Part Number	Description	Batch
8	D2745	Bushing	B25840 /

26.0	AN644A	Bolt
------	--------	------



Comment: Qty.: 4.0000 Each(s)/Unit Total : 4.0000 Each(s)

Pick:

Qty	Part Number	Description	Batch
4	AN6-44A	Bolt	M18369 /

27.0	MS21042L6	Nut
------	-----------	-----



Comment: Qty.: 4.0000 Each(s)/Unit Total : 4.0000 Each(s)

Pick:

Qty	Part Number	Description	Batch
4	MS21042L6	Nut (or -6)	M17614 /

28.0	AN332A	Bolt
------	--------	------



Comment: Qty.: 4.0000 Each(s)/Unit Total : 4.0000 Each(s)

Pick:

Qty	Part Number	Description	Batch
4	AN3-32A	Bolt	M18706

a.m. 03-04-18

2

Date: Wednesday, 3/8/2006 10:29:44 AM
User: Kim Johnston

Process Sheet

Customer: CU-DAR001 Dart Helicopters Services

Drawing Name: 350 SKIDTUBE ASSEMBLY RH

Job Number: 26093

Part Number: D350636012

Job Number:



Seq. #:

Machine Or Operation:

Description :

3-Install D2745 Bushing as per Dwg. D2750 Detail M

4-Install A3235-020-935 Plug as per Dwg. D2750 Detail L

5-Install AN3-6A Bolt as per Dwg. D2750 Detail Q

Am 06-04-18 (1)

34.0

QC5

INSPECT WORK TO CURRENT STEP



Comment: INSPECT WORK TO CURRENT STEP

FC

06 04 18

(1)

35.0

PACKAGING 1

PACKAGING RESOURCE #1



Comment: PACKAGING RESOURCE #1

Pick Packing Kit

36.0

D2741

Blade



Comment: Qty.: 1.0000 Each(s)/Unit Total: 1.0000 Each(s)

Pick: Kit Picking

Qty Part Number

Description

Batch

1 D2741

Blade

024730V

37.0

AN960JD816

1/2" washer, Alum



Comment: Qty.: 2.0000 Each(s)/Unit Total: 2.0000 Each(s)

Pick: Kit Picking

Qty Part Number

Description

Batch

2 AN960JD816

Washer

076956 V

38.0

MS21083N8

Nut



Comment: Qty.: 2.0000 Each(s)/Unit Total: 2.0000 Each(s)

Pick: Kit Picking

Qty Part Number

Description

Batch

2 MS21083N8

Nut

019099 V

Date: Wednesday, 3/8/2006 10:29:44 AM
User: Kim Johnston

Process Sheet

Customer: CU-DAR001 Dart Helicopters Services

Drawing Name: 350 SKIDTUBE ASSEMBLY RH

Job Number: 26093

Part Number: D350636012

Job Number:



Seq. #:

Machine Or Operation:

Description :

39.0

AN816A

Bolt



Comment: Qty.: 2.0000 Each(s)/Unit Total : 2.0000 Each(s)

Pick: Kit Picking

Qty Part Number

Description

Batch

2 AN8-16A

Bolt

M157600 N

R 06/04/25 (1)

40.0

QC4

INSPECT 100% KITS FOR COMPLETENESS



Comment: INSPECT 100% KITS FOR COMPLETENESS

P 06/04/25 (1)

41.0

PACKAGING 1

PACKAGING RESOURCE #1



Comment: PACKAGING RESOURCE #1

Package as per PPP D350-636-012

see D

P 06/04/26 (1)

42.0

DC

DOCUMENT CONTROL



Comment: DOCUMENT CONTROL

Inspection Level 21

D 06/04/27 (1)

Job Completion



W 06/04/27



DESIGN <i>[Signature]</i>	DRAWN BY <i>[Signature]</i>	DART AEROSPACE USA, INC. BELLEVUE, WA	
CHECKED <i>[Signature]</i>	APPROVED <i>[Signature]</i>	DRAWING NO. D2750	REV. C SHEET 1 OF 4
DATE 98.11.18		TITLE 350 SKIDTUBE ASSEMBLY SCALE NTS	
A	98.04.16	NEW ISSUE	
B	98.09.01	CHANGE MS24694-S293 TO AN8-16A	
C	98.11.18	ADD D2750-3/D2750-4 INCORPORATE D2738 AND D2740	
C1	<i>[Signature]</i> 98.01.20	CHANGE QTY HEADHOLE HOLES, AS MANUFACTURED	

RELEASED
98.12.16 DS

Qty -041	Qty -042	Qty -043	Qty -044	Part Number	Description
X				D2750-041	SKIDTUBE ASSEMBLY, LH
	X			D2750-042	SKIDTUBE ASSEMBLY, RH
		X		D2750-043	SKIDTUBE ASSEMBLY, LH
			X	D2750-044	SKIDTUBE ASSEMBLY, RH
3	3	3	3	D2648-3	WEARPAD
2	2	2	2	D2648-5	WEARPAD
1	1	1	1	D2739	WEB
1	1	1	1	D2741	BLADE
1		1		D2742-1	BLADE FITTING, LH
	1		1	D2742-2	BLADE FITTING, RH
8	8	8	8	D2743	SPACER
1	1	1	1	D2744	CAP
8	8	8	8	D2745	BUSHING
1				D2750-1	SKIDTUBE WELDMENT, LH
	1			D2750-2	SKIDTUBE WELDMENT, RH
		1		D2750-3	SKIDTUBE WELDMENT, LH
			1	D2750-4	SKIDTUBE WELDMENT, RH
8	8			A3235-020-935	PLUG
40	40	40	40	AN3-5A	BOLT
8	8	8	8	AN3-6A	BOLT
4	4			AN3-32A	BOLT
4	4	4	4	AN6-44A	BOLT
2	2	2	2	AN8-16A	BOLT
1	1	1	1	AN8-35A	BOLT
3	3	3	3	MS21083N8	NUT
4	4			MS21042L3 OR MS21042-3	NUT
4	4	4	4	MS21042L6 OR MS21042-6	NUT
4	4	4	4	AN960JD10	WASHER
44	44	44	44	AN960JD10L	WASHER
4	4	4	4	AN960JD816	WASHER
44 42	44 42	44 42	44 42	ALS4-1032-225 or AKS4-1032-225 or ALS7-1032-225 or AKS7-1032-225	INSERT

EFFECTIVE	DEOS
D20 4137 DS	D20 4137 DS
98.01.19 DS	98.10.21 DS



DESIGN <i>JH</i>	DRAWN BY <i>CP</i>	DART AEROSPACE USA, INC. BELLEVUE, WA	
CHECKED <i>JH</i>	APPROVED <i>KE</i>	DRAWING NO. D2750	REV. C SHEET 2 OF 4
DATE 98.11.18		TITLE 350 SKIDTUBE ASSEMBLY	SCALE NTS

GENERAL NOTES:


1. TOLERANCES ARE PER DART QSI 018 UNLESS OTHERWISE NOTED.
2. MAKE FROM D2600-3 EXTRUSION (INITIAL LENGTH = 120.0).
3. DAMAGE TOLERANCE ON BENDING:
THERE SHOULD BE NO VISIBLE WRINKLES IN THE BEND FROM THE GROUND TO A HEIGHT OF 12 INCHES ABOVE THE GROUND. NO GOUGING IS ACCEPTABLE IN THE FLAT PORTION OF THE TUBE. GOUGES UP TO 0.020 ARE ACCEPTABLE IN THE BENT PORTION OF THE TUBE. TUBE O.D. SHOULD BE 3.150 ± 0.010 IN THE FLAT PORTION OF THE TUBE. TUBE O.D. SHOULD BE 3.15 ± 0.030 IN THE BENT PORTION OF THE TUBE.
4. ALL HOLES DRILLED ON CENTERLINES EXCEPT THOSE NOTED BY SECTIONS E-E AND F-F.
5. WELDING TO BE DONE PER DART QSI 004.
6. FINAL CONFIGURATION SHOULD HAVE THE FOLLOWING MINIMUM MECHANICAL PROPERTIES:
MINIMUM YIELD TENSILE STRENGTH = 35 ksi
MINIMUM ULTIMATE TENSILE STRENGTH = 38 ksi
7. FINISH:
ACID ETCH, ALODINE ASSEMBLY PER DART QSI 005 4.1 PRIOR TO INSTALLING D2734 WEB.
POWDER COAT WHITE (REF. 4.3.5.1) PER DART QSI 005 4.3
BLACK ANTI-SKID PAINT AS INDICATED TO 1.0 ABOVE SKIDTUBE CENTER-LINE PER DART 005 4.4 (OPTIONAL).
8. INSTALL ALS4-1032-225 INSERTS AFTER FINISH AS INDICATED IN D2750-1/-2/-3/-4 WELDING DETAIL ON PAGE 4.
9. D2742-1 (OR D2742-2) BLADE FITTING AND AN3-5A/AN3-6A WEARSHOE SCREWS TO BE INSTALLED USING SIKAFLEX-241 (OR EQUIVALENT) SEALANT.

EFFECTIVE	DEOs
DEO 9133 98.01.19 DS	DEO 9157 99.10.21 DS


RELEASED
99.12.16 DS

Copyright 1998 by DART AEROSPACE USA, INC.

SHOP COPY
RETURN TO
ENGINEERING
UNCONTROLLED COPY
SUBJECT TO AMENDMENT
WITHOUT NOTICE
WORK ORDER
NO. 26093



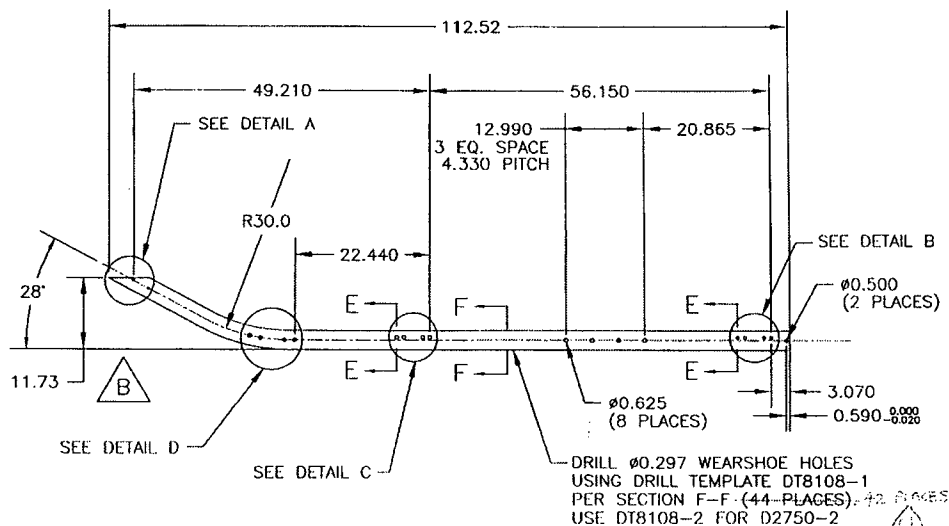


D2750-1 LH SKIDTUBE (SHOWN)
D2750-2 RH SKIDTUBE (OPPOSITE)

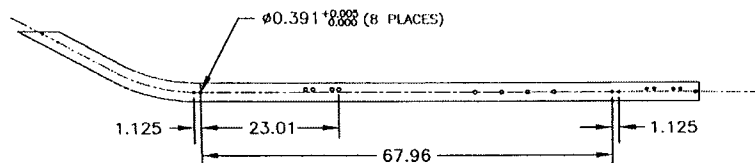


D2750-3 LH SKIDTUBE (SHOWN)
D2750-4 RH SKIDTUBE (OPPOSITE)

D2750-3/-4 ARE THE SAME AS D2750-1/-2 EXCEPT THAT DETAIL D HOLES
ARE REPLACED BY HOLE CONFIGURATION GIVEN ABOVE.

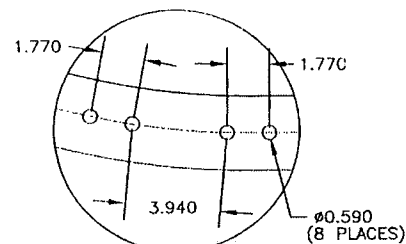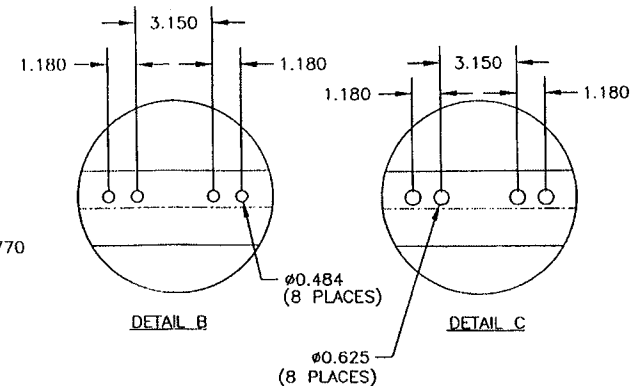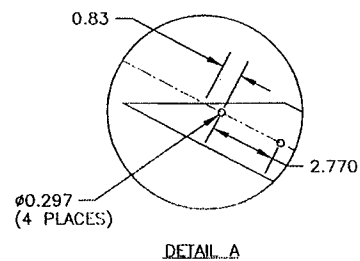

(ALL DIMENSIONS ARE
STRAIGHT LINE DIMENSIONS)

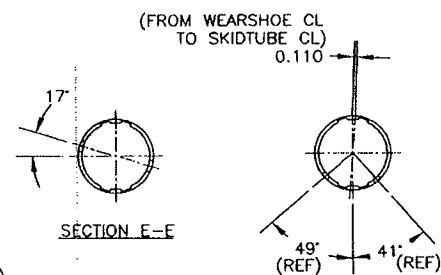


RELEASED
98.12.16 DS

EFFECTIVE	DEOS
000 4133 98.01.19 DS	000 4137 98.01.21 DS


DESIGN #4	DRAWN BY JP	DART DART AEROSPACE USA, INC. BELLINGHAM, WA
CHECKED PA	APPROVED KE	DRAWING NO. D2750
DATE 98.11.18		TITLE 350 SKIDTUBE ASSEMBLY
		REV. C SHEET 3 OF 4 SCALE 1:20

NO. 26093
WORK ORDER
SUBJECT TO AMENDMENT
WITHOUT NOTICE
UNCONTROLLED COPY
ENGINEERING
RETURN TO
SHOP COPY


D2750-1/-2/-3/-4 WELDING DETAIL
(FLOAT ATTACHMENT HOLES REMOVED)
D2750-1/-3 SHOWN (D2750-2/-4 OPPOSITE)

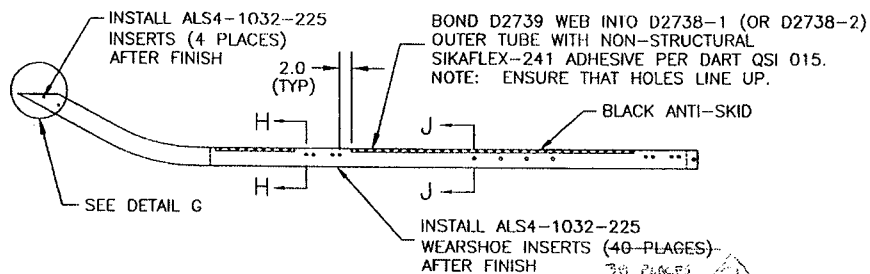

DETAIL G

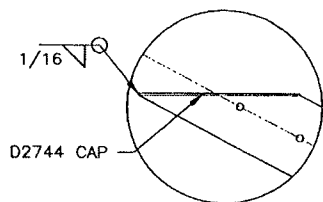


SECTION H-H

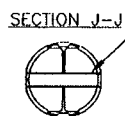

WELDING INSTRUCTIONS

1. CHAMFER HOLE 0.050 X 45°
2. INSERT D2743 SPACER
3. WELD INTO PLACE
4. GRIND FLUSH
5. DRILL OUT SPACER TO Ø0.484
6. SPOT FACE Ø0.750 (SECTION J-J ONLY)


DETAIL K

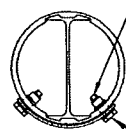

USE AN3-6A BOLTS FOR INSTALLING AFT D2648-3 WEARPAD


AN3-5A BOLT (1)
AN960JD10L WASHER (1)
(44 PLACES)
(42 PLACES)

DETAIL M

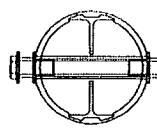


AN6-44A BOLT (1)
D2745 BUSHING (2)
MS21042L6 NUT (1)
(4 PLACES)

DETAIL P

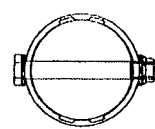


AN8-35A BOLT (1)
AN960JD816 WASHER (2)
MS21083N8 NUT (1)

DETAIL Q

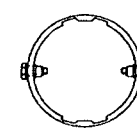


AN3-6A BOLT (1)
AN960JD10 WASHER (1)
(4 PLACES)

DETAIL L

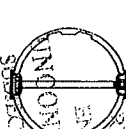


AN3-32A BOLT (1)
A3235-020-935 PLUG (2)
MS21042L3 NUT (1)
(4 PLACES, FOR D2750-041/-042 ONLY)

DETAIL N

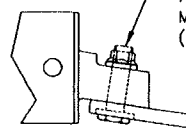


AN8-16A BOLT (1)
AN960JD816 WASHER (1)
MS21083N8 NUT (1)
(2 PLACES)

D2750-041/-042 ASSEMBLY
D2750-041 SHOWN (D2750-042 OPPOSITE)

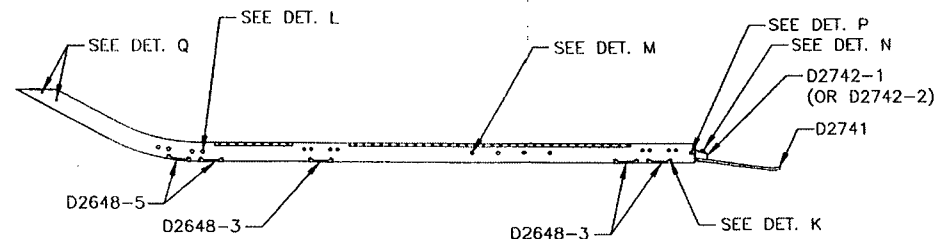

D2750-043/-044 ASSEMBLY
D2750-043 SHOWN (D2750-044 OPPOSITE)

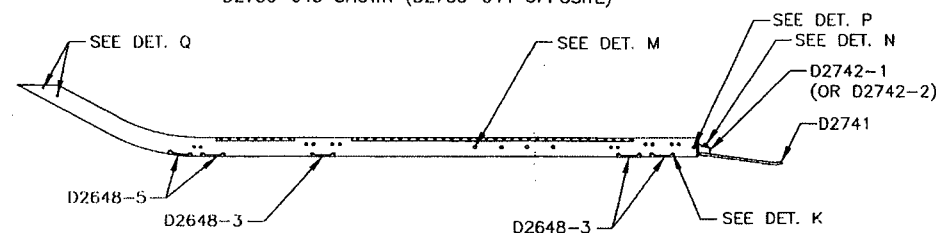

RELEASED
98.12.16 DS

EFFECTIVE	DEOs
DEC 9 1997 98.01.19 DS	DEC 9 1997 98.10.21 DS

DESIGN	DRAWN BY	DART DART AEROSPACE USA, INC. DALLAS, TX	REV. C
CHECKED 98.11.18	APPROVED KE	DRAWING NO. D2750	SHEET 4 OF 4
DATE 98.11.18		TITLE 350 SKIDTUBE ASSEMBLY	SCALE 1:20

NO. 26093
WORK ORDER
WITHOUT NOTICE
SUBJECT TO AMENDMENT
RETURN TO
ENGINEERING
FOR CONTROLLED COPY
SHOP COPY